PIET POTGIETERSRUST TOWN AND TOWNLANDS No. 44-KS
REMAINDER OF PORTION 80

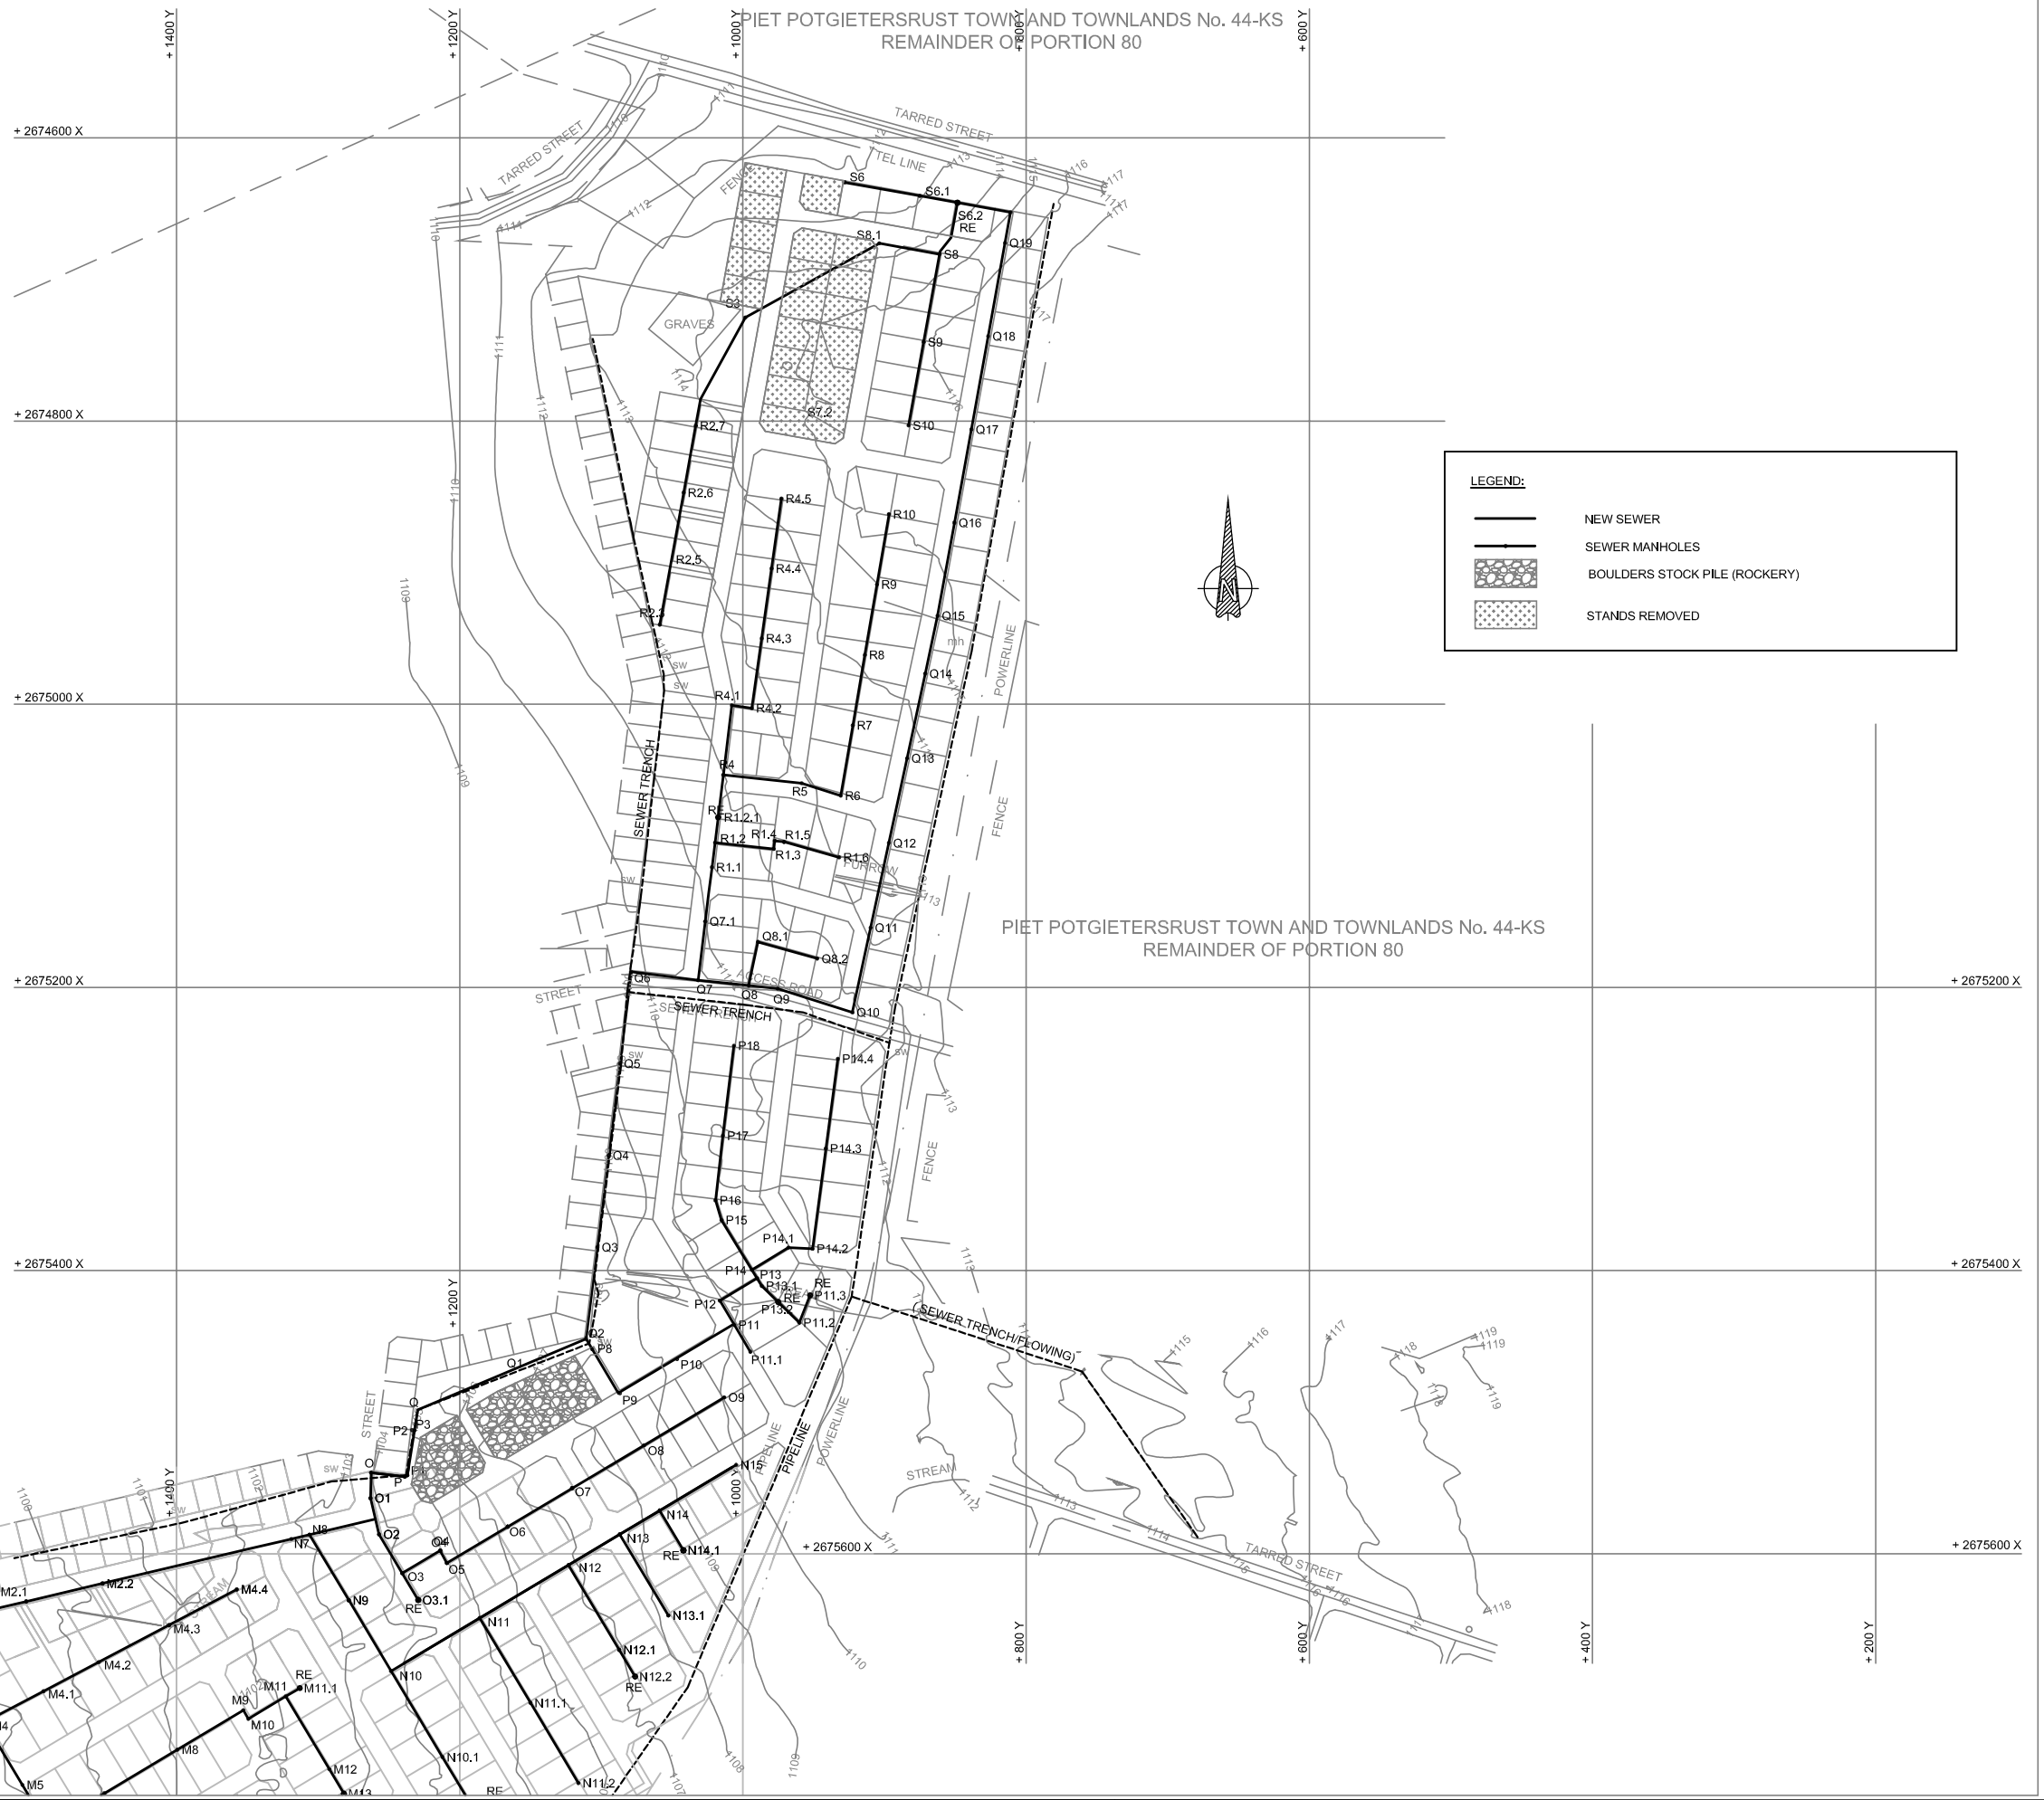

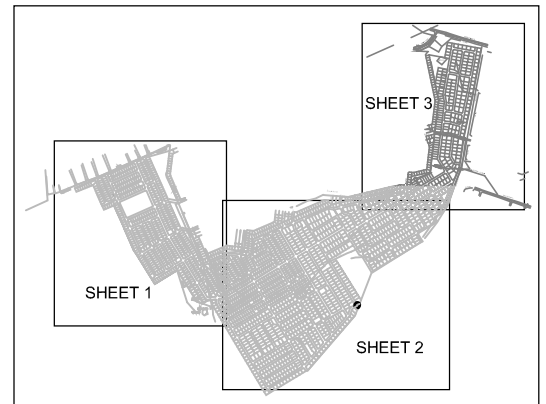

KEY PLAN

LEGEND:

- NEW SEWER
- SEWER MANHOLES
- BOULDERS STOCK PILE (ROCKERY)
- STANDS REMOVED

PIET POTGIETERSRUST TOWN AND TOWNLANDS No. 44-KS
REMAINDER OF PORTION 80

REV. No.	DATE	DESCRIPTION	APPROVED BY
00	08/05/2008	ISSUED FOR CONSTRUCTION	M.S.F
01	13/04/2011	AS BUILT	E.M

AS BUILT
INSPECTION BY
(print name) (signature)
(print Prof. Reg. No.) (date)

SFC ENGINEERS
BOARDING TO NEW HEIGHTS
Civil Engineers • Structural Engineers
Development Managers • Facilities Managers
2nd FLOOR, STANDARDBANK BUILD. 49 LANDROS MARIE ST. POLOKWANE.
P O BOX 4879 POLOKWANE 0700
Tel.: (015) 291-5866 Fax: (015) 291-5353

DESIGN BY	DRAWN BY
I.G.M	A.V.G
DESIGN CHECKED BY	DRAWING CHECKED BY
M.S.F	I.G.M
DATE	
08/05/2008	

CLIENT
DEPARTMENT OF LOCAL GOVERNMENT & HOUSING
28 MARKET STREET
POLOKWANE
0699

PROJECT
MUNICIPAL SERVICES
MOKOPANE EXT. 20

TITLE
SEWER LAYOUT

DRAWING NUMBER
1350/CE/SEW/AB/LAY/003

SHEET 3 OF 3

SCALE:	SIZE:	REV. No.:
1:2500	A1	01