PIET POTGIETERSRUST TOWN AND TOWNLANDS No. 44-KS
REMAINDER OF PORTION 80

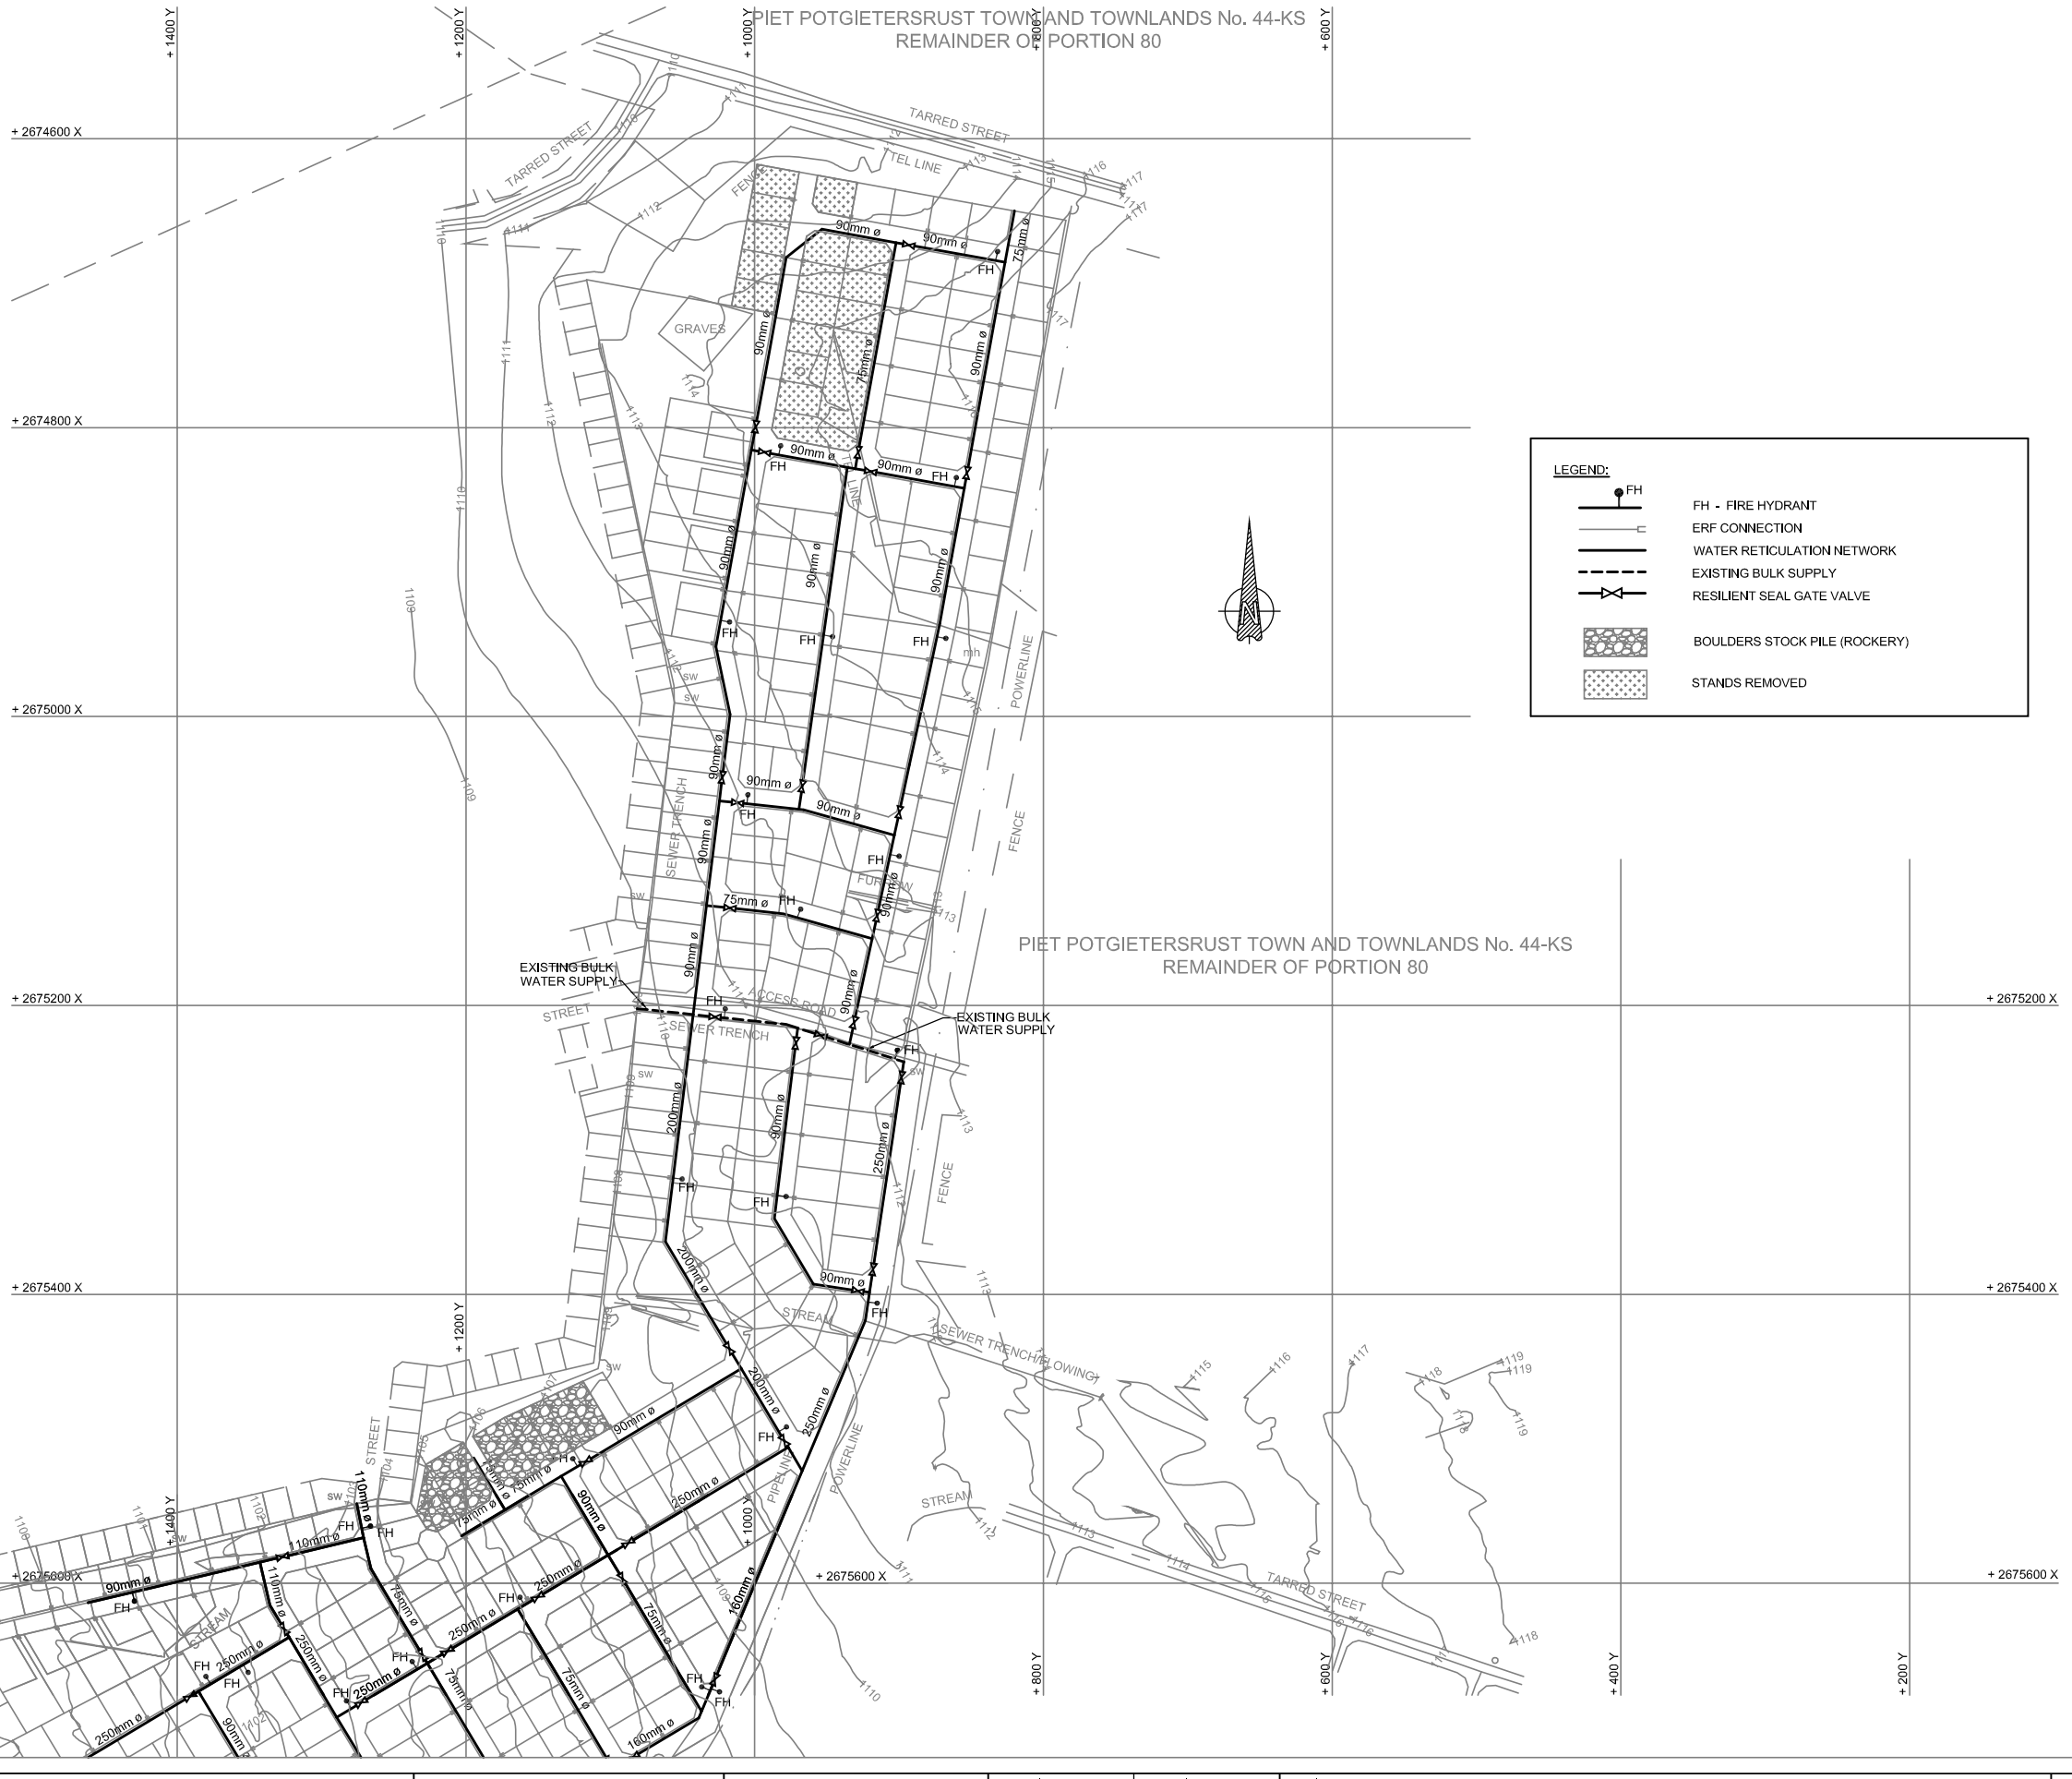

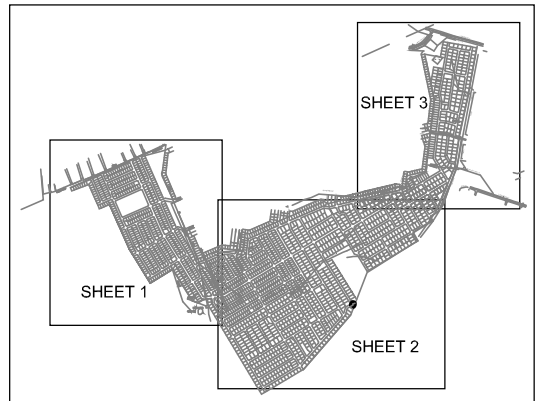

KEY PLAN

LEGEND:

- FH - FIRE HYDRANT
- ERF CONNECTION
- WATER RETICULATION NETWORK
- EXISTING BULK SUPPLY
- RESILIENT SEAL GATE VALVE
- BOULDERS STOCK PILE (ROCKERY)
- STANDS REMOVED

REV. No.	DATE	DESCRIPTION	APPROVED BY
00	08/05/2008	ISSUED FOR CONSTRUCTION	M.S.F
01	14/04/2011	AS BUILT	E.M

AS BUILT
INSPECTION BY
(print name) (signature)
(print Prof. Reg. No.) (date)

SFC ENGINEERS
BUILDING TO NEW HEIGHTS
Civil Engineers • Structural Engineers
Development Managers • Facilities Managers
2nd FLOOR, STANDARDBANK BUILD.
48 LANGROS MARIE ST.
POLOKWANE
P O BOX 4879
POLOKWANE
0700
Tel : (015) 291-5866
Fax: (015) 291-5353

DESIGN BY |	DRAWN BY |
I.G.M	A.V.G
DESIGN CHECKED BY |	DRAWING CHECKED BY |
I.G.M	M.S.F
DATE | 08/05/2008	

CLIENT|
DEPARTMENT OF LOCAL GOVERNMENT & HOUSING
28 MARKET STREET
POLOKWANE
0699

PROJECT|
MUNICIPAL SERVICES
MOKOPANE EXT. 20

TITLE|
WATER LAYOUT

DRAWING NUMBER|
1350/CE/WAT/AB/LAY/003
SHEET 3 OF 3

SCALE:	SIZE:	REV. No.:
1:2500	A1	01